



Section 171 - Zebra Crossing Layout - 1:250

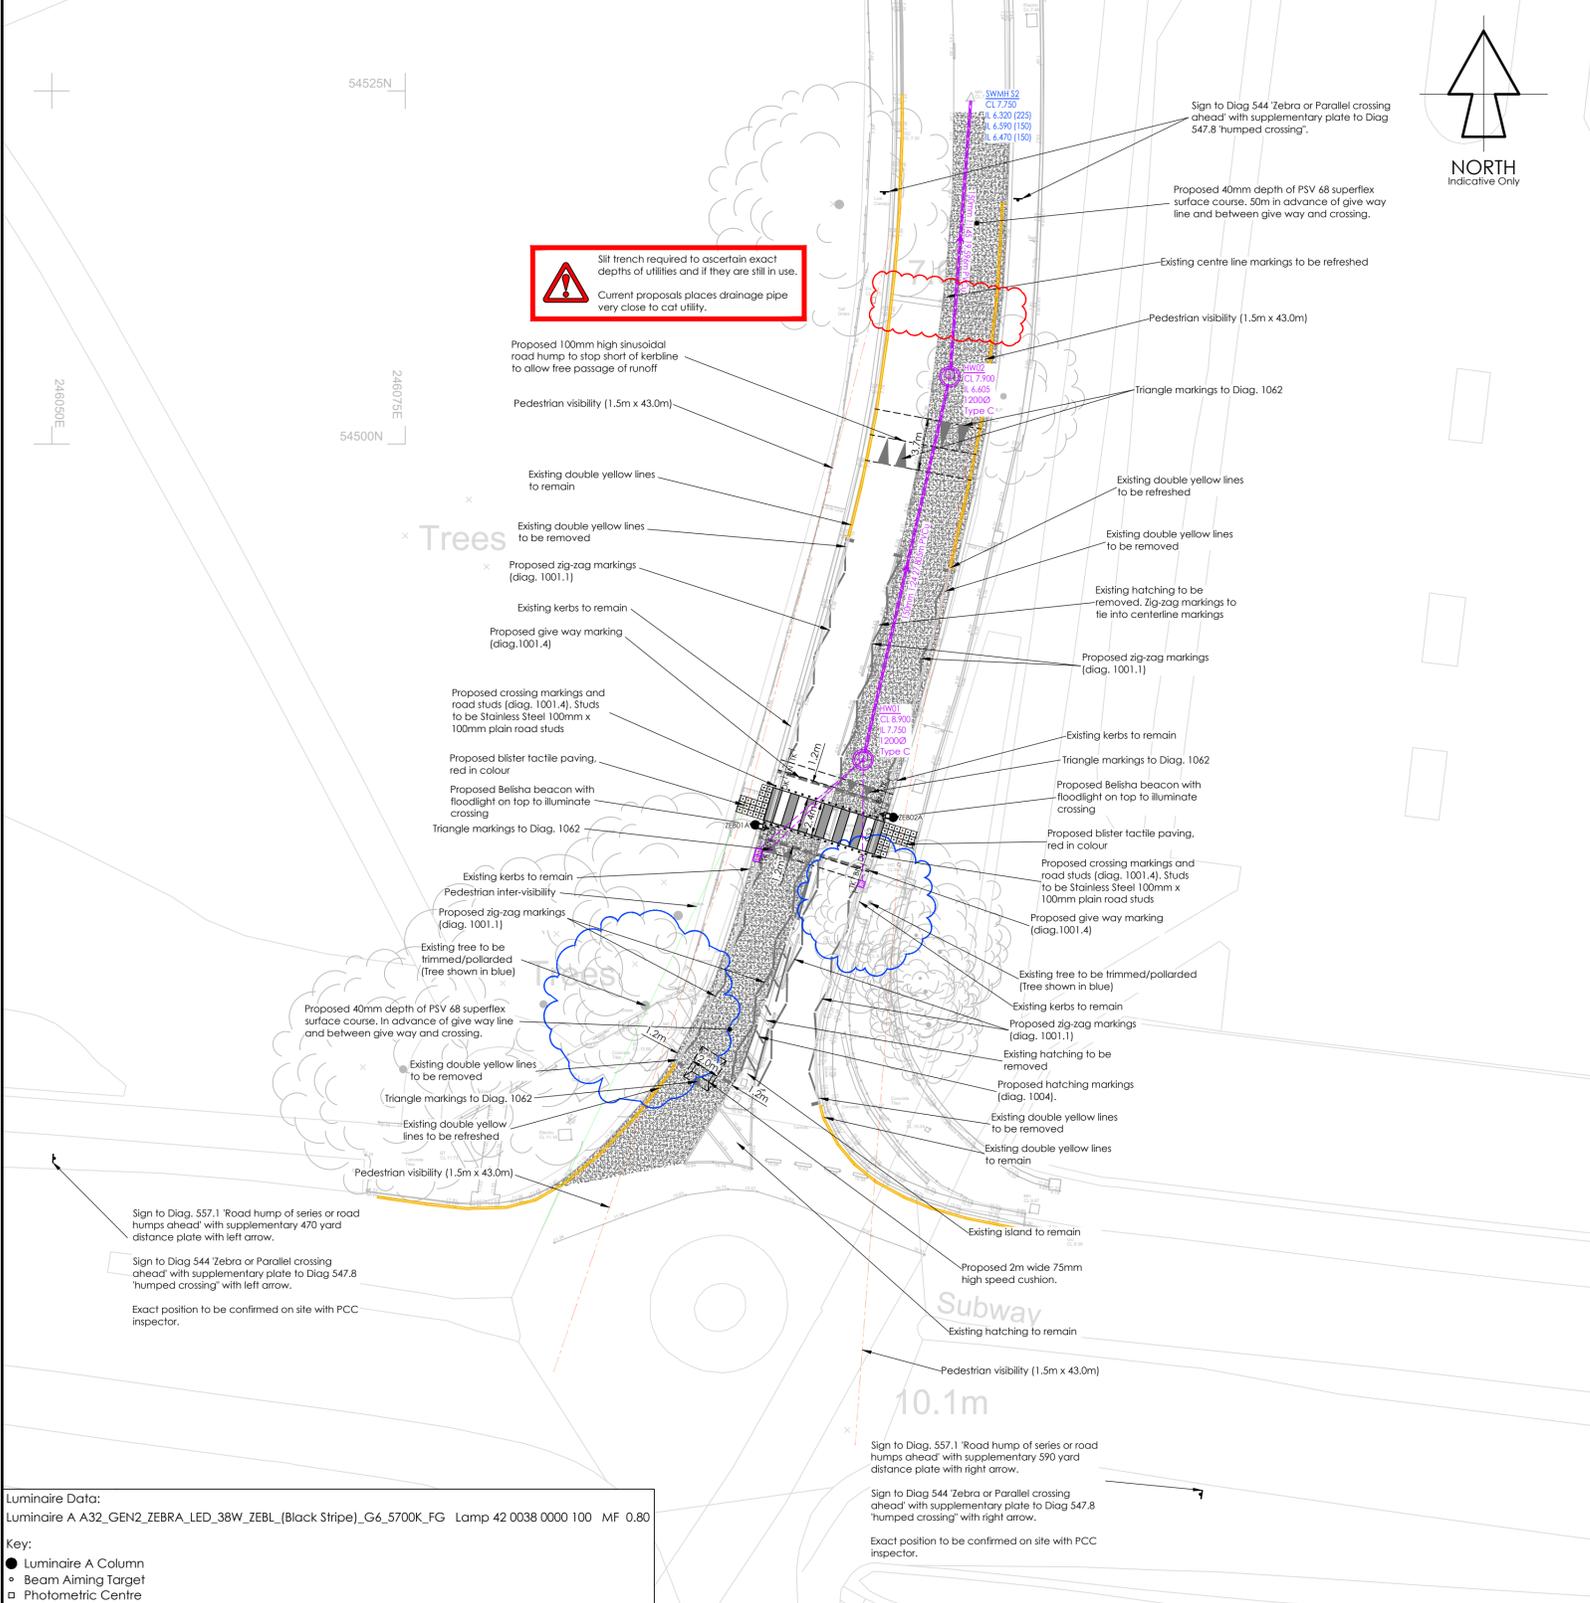

- NOTES:
- DO NOT SCALE from this drawing as liable to distort
 - This drawing is to be read in conjunction with all other relevant Engineers, Architects and Specialists drawings and specifications
 - Any variations with line, level or specification of the proposed works should be reported to the Engineer prior to commencement
- KERB LEGEND:
- HB2 Half Battered kerb type HB2 with 125mm upstand.
 - CK Conservation Kerb type.
 - BN Bull Nosed Kerb type BN with 50mm upstand
 - CS2 Square Channel kerb type CS2 with 0mm upstand.
 - TK Transition kerb type TK.
 - DK Dropper kerb type DK.

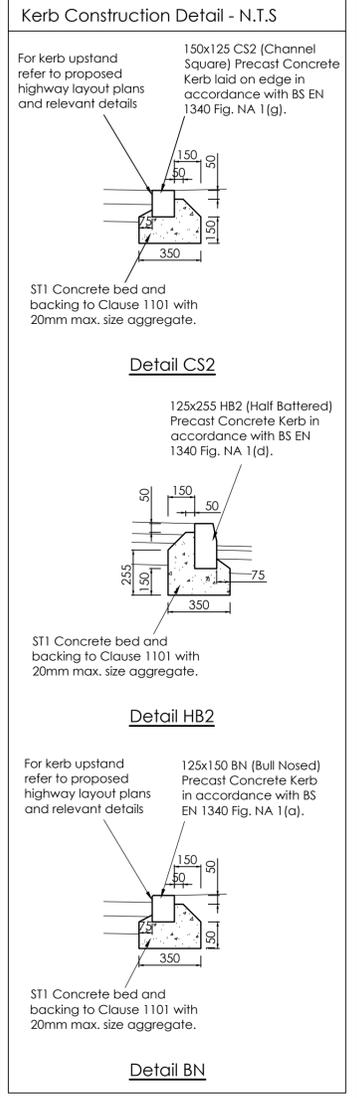

Luminaire Data:
 Luminaire A A32_GEN2_ZEBRA_LED_38W_ZEBL_(Black Stripe)_G6_5700K_FG Lamp 42 0038 0000 100 MF 0.80

Key:
 ● Luminaire A Column
 ○ Beam Aiming Target
 □ Photometric Centre

Zebra Crossing Location Plan - 1:1250



Rev	Date	Description	By
P08	12/01/25	Updated following PCC comments	8K/DJR
P07	04/11/25	Updated following PCC comments	8K/DJR
P06	20/10/25	Updated following PCC comments	8K/DJR
P05	29/09/25	PSV 68 note updated	8K/DJR
P04	20/08/25	S278 reference amended to S171	8K/DJR
P03	19/08/25	Tree removal note amended	8K/DJR
P02	15/08/25	Updated following on site meeting	8K/DJR
P01	18/10/24	Initial issue	8K/DJR
Rev	Date	Description	By
			8K/DJR

Drawing revision denotes the following stages: P - Preliminary, T - Tender, C - Construction, R - Record/As Built.

PRELIMINARY

Civil & Structural Chartered Engineers
 Hems Court, Longbrook Street
 Exeter, Devon, EX4 6AP
 T. 01392 421600
 sands@sands-consultants.co.uk
 www.sands-consultants.co.uk

Sands
 Est. 1991



Client

Project Title
PROPOSED DEVELOPMENT AT BRICKFIELDS ACADEMY PLYMOUTH DEVON

Drawing Title
KINGS ROAD ZEBRA CROSSING - SOUTH

Scale/Size	Date
AS SHOWN/A1	October 2024
Drawn	Checked
Ben Kennell	David Rowe
Sands Project No.	Client Project No.
2023.098	-
Drawing No.	Revision
2103	P08